

HAYS CISD ELEMENTARY PLAN B



Circle shows area with proposed changes.

Red line denotes current boundary.

Purple color denotes areas proposed to become new attendance zone.

Legend

Schools



- ELEM
- MID
- HIGH
- FUTURE

2021-22 Elementary Boundaries

- 2021-22 Elementary Boundaries

Planning Areas

- BLANCO VISTA
- BUDA
- CAMINO REAL
- CARPENTER HILL
- ELEM 15
- ELM GROVE
- FUENTES
- HEMPHILL
- KYLE
- NEGLEY
- PFLUGER
- SCIENCE HALL
- TOBIAS
- TOM GREEN
- UHLAND

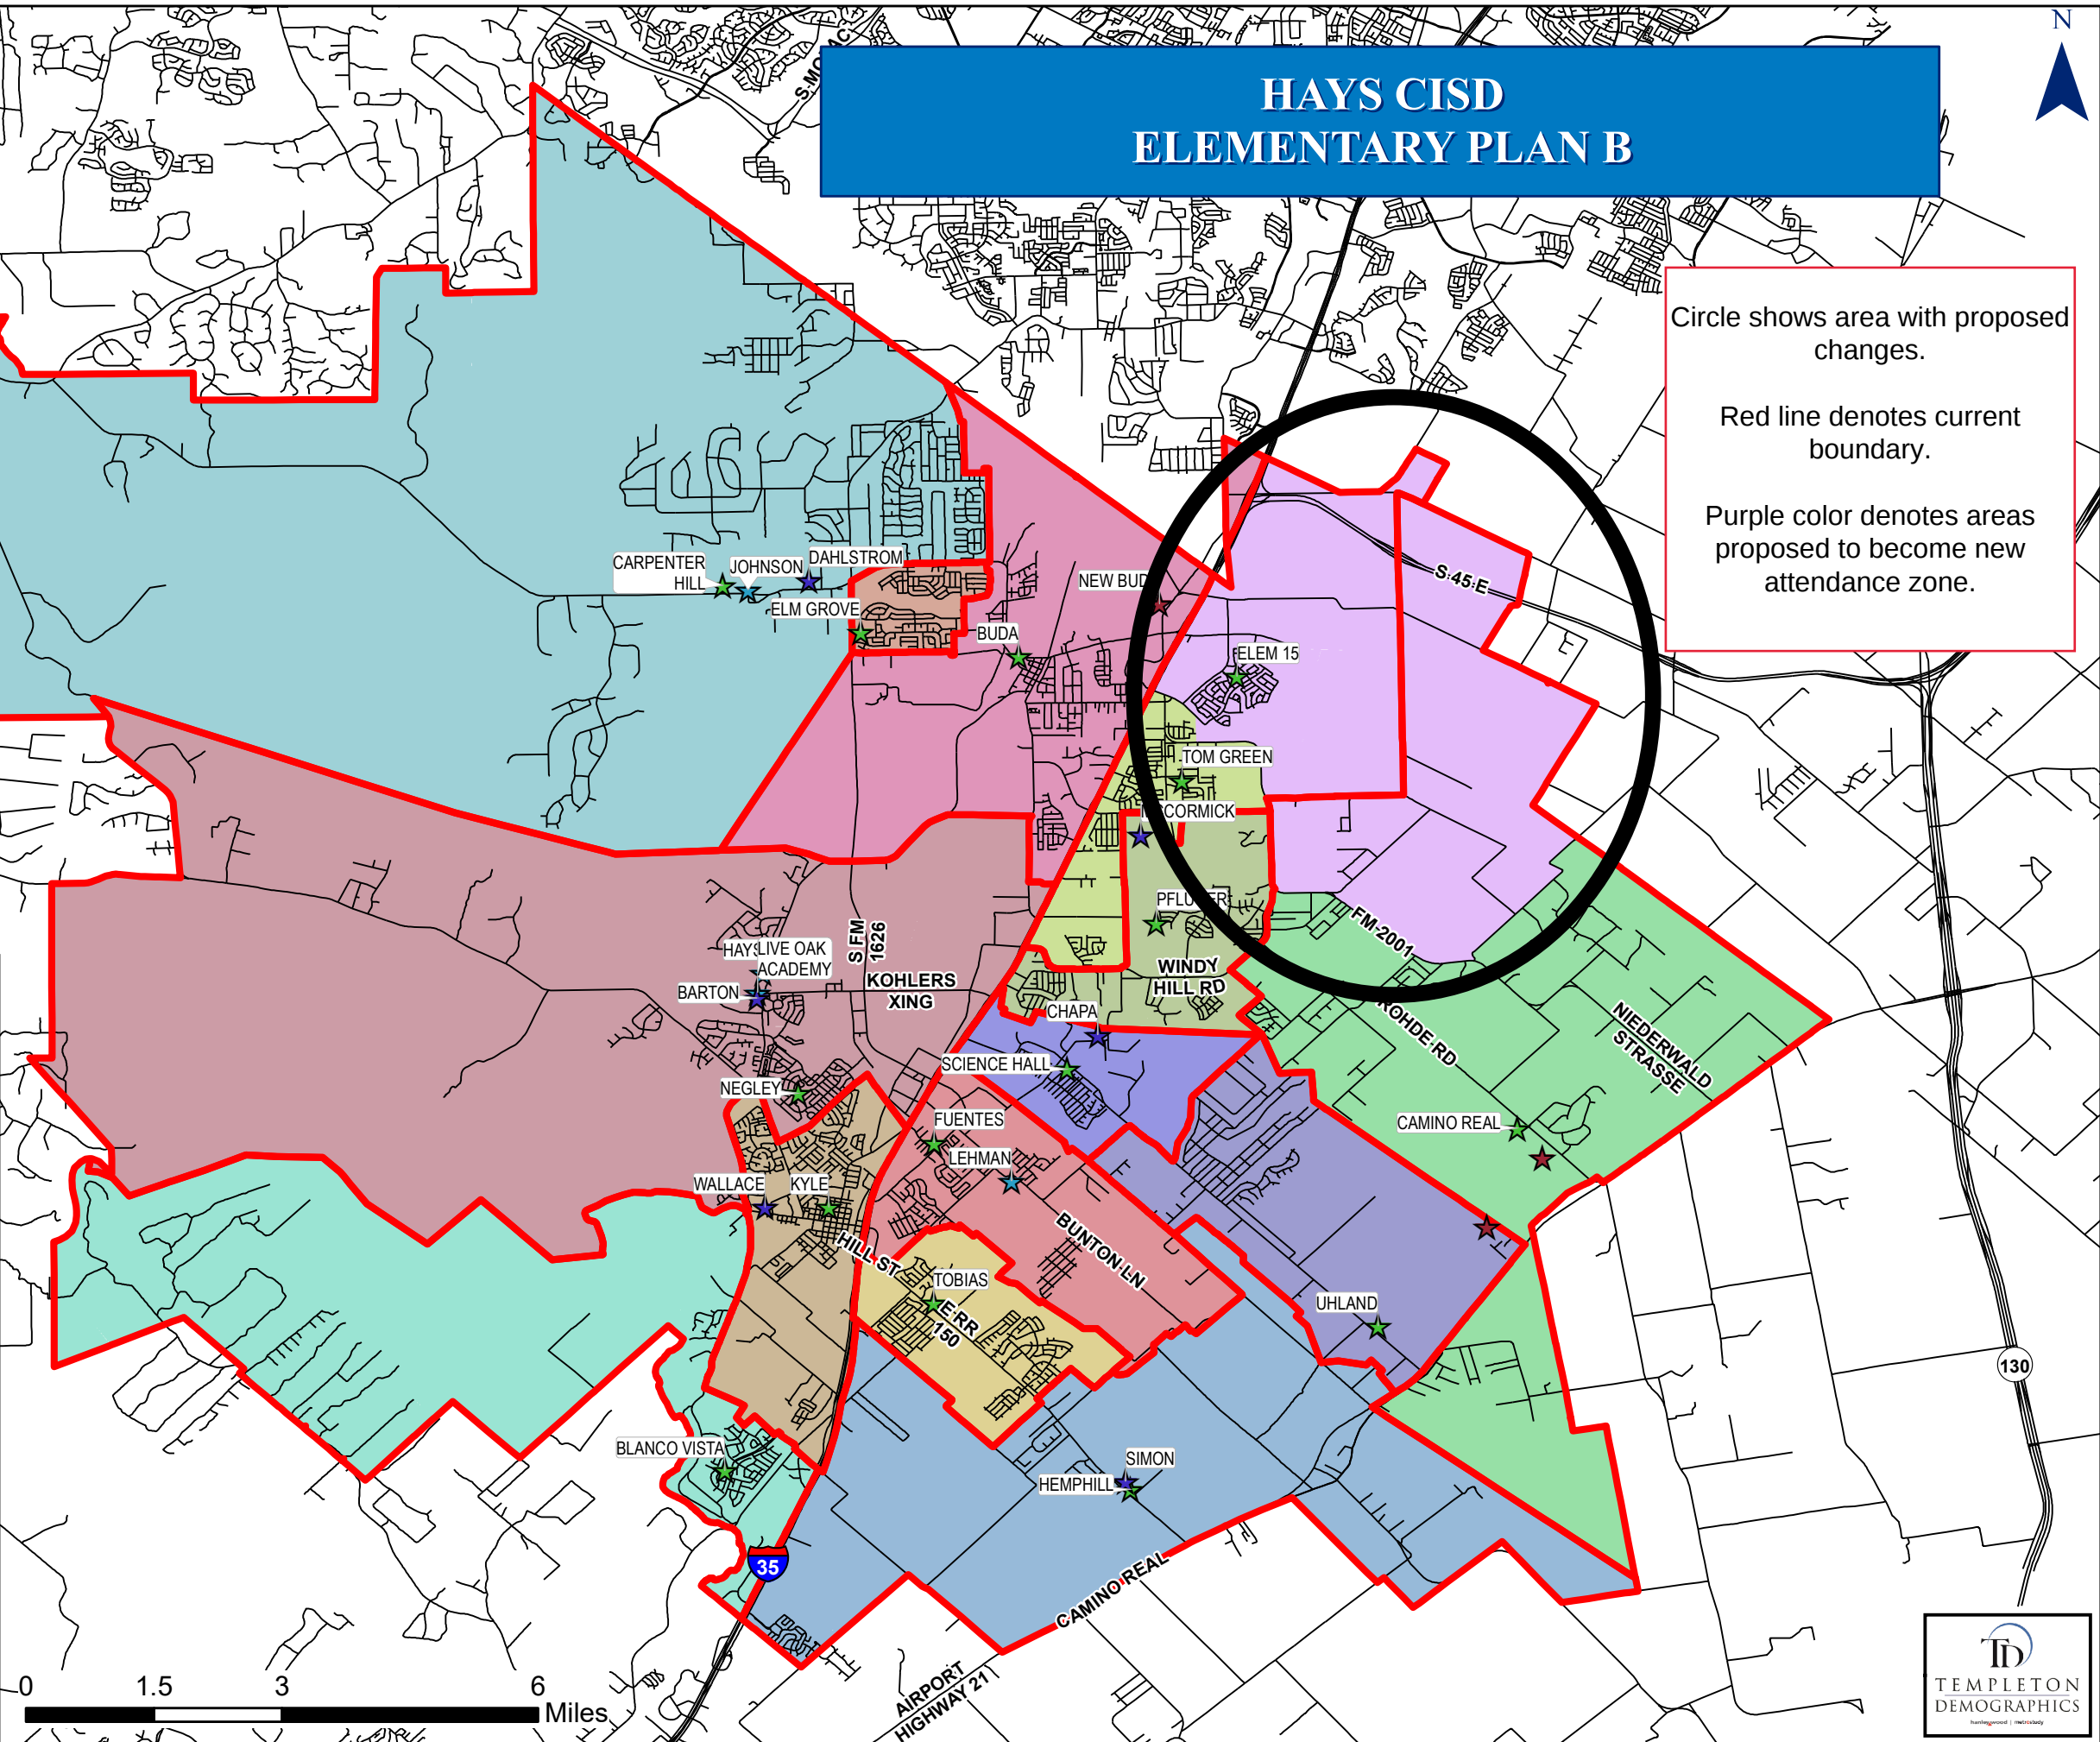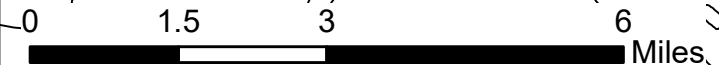

HAYS CISD ELEMENTARY 15 REZONING PLAN B CHANGES

This is a general written description of the territorial changes that exist on this plan compared with the current Hays CISD elementary attendance zone map:

1. **TGES to Elementary #15:** Move portions of the existing Tom Green Elementary attendance zone north of Overpass Road and White Wing Trail, and north and east of FM 2001 to the new Elementary #15 attendance zone. (This includes the entirety of the Sunfield subdivision.)
2. **CRES to Elementary #15:** Move portions of the existing Camino Real Elementary attendance zone north of FM 107 from FM 212 to FM 120 to the new Elementary #15 attendance zone.
3. **CRES to Elementary #15:** Move portions of the existing Camino Real Elementary attendance zone north of FM 2001 and west of FM 120.

HAYS CISD

Plan B Elementary Forecast Report

SCHOOL	CAPACITY	2021/22	2022/23	2023/24	2024/25	2025/26	2026/27	2027/28	2028/29	2029/30	2030/31	2031/32
BLANCO VISTA	800	713	774	824	858	880	902	917	930	952	980	1,011
BUDA	900	682	718	780	806	846	879	903	939	970	1,020	1,070
CAMINO REAL	800	690	722	751	750	748	767	786	782	787	780	774
CARPENTER HILL	800	618	635	666	707	737	774	805	843	869	893	916
ELEM 15		373	491	630	767	897	1,037	1,177	1,317	1,426	1,553	1,682
ELM GROVE	982	762	775	775	787	787	776	800	800	814	830	846
FUENTES	720	657	705	776	837	894	907	954	1,028	1,107	1,212	1,333
HEMPHILL	720	436	500	586	659	738	785	857	926	997	1,085	1,161
KYLE	770	576	603	661	709	712	738	748	760	775	798	819
NEGLEY	967	908	1,001	1,109	1,225	1,327	1,469	1,610	1,757	1,908	2,064	2,211
PFLUGER	800	778	789	809	830	838	846	890	922	930	934	945
SCIENCE HALL	720	593	656	705	762	833	864	872	880	884	892	886
TOBIAS	720	657	697	754	798	858	900	909	912	918	924	928
TOM GREEN	714	525	512	539	544	549	558	565	583	617	655	688
UHLAND	900	720	740	771	775	814	881	967	1,017	1,068	1,112	1,161
TOTAL	11,313	9,688	10,318	11,136	11,814	12,458	13,083	13,760	14,396	15,022	15,732	16,431

YELLOW 95% - 100% CAPACITY
ORANGE 100% - 105% OVER CAPACITY
RED > 105% OVER CAPACITY